



FLOOR 4 | FLOOR PLAN

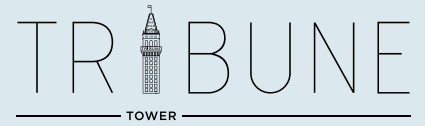

As-Built Full Floor Plan
±10,296 SF

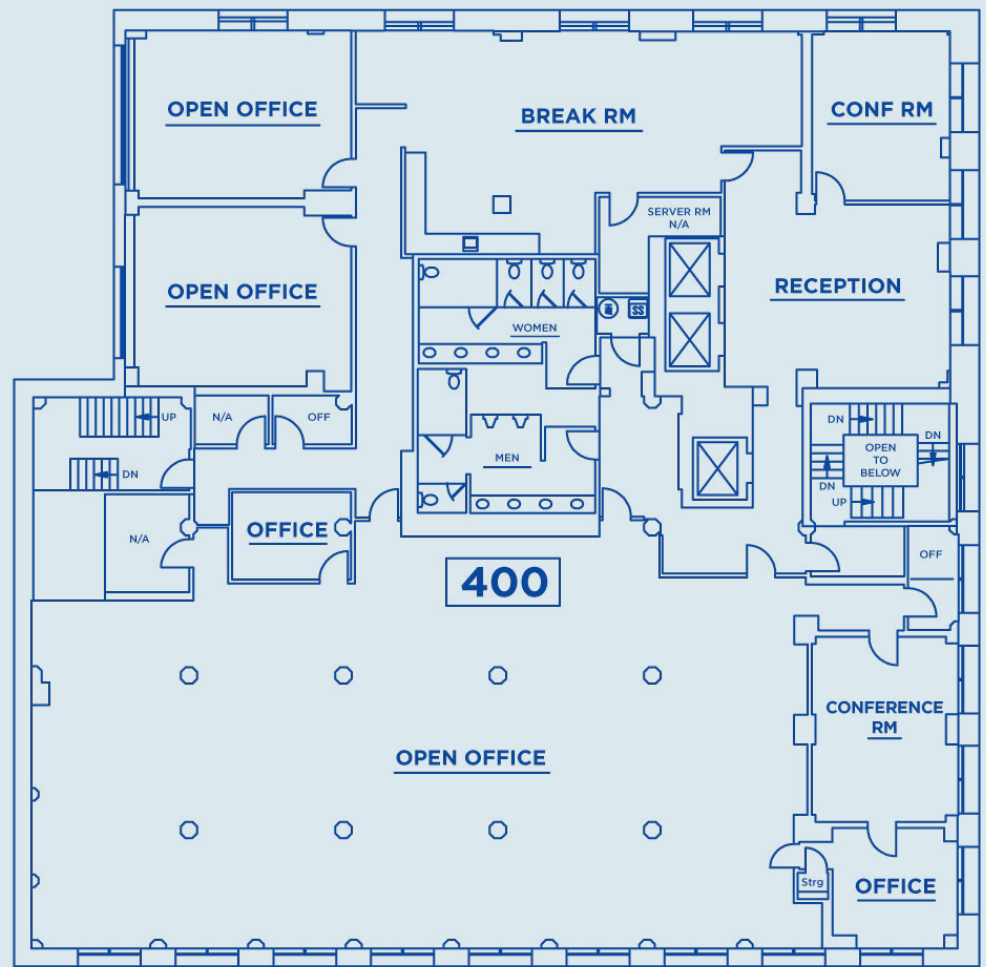

TRIBTOWER.COM

JOHN DOLBY
Executive Director
+1 510 267 6027
john.dolby@cushwake.com
LIC #00870630

DANE HOOKS
Managing Director
+1 510 267 6025
dane.hooks@cushwake.com
LIC #01900402

©2017 Cushman & Wakefield. NO WARRANTY OR REPRESENTATION, EXPRESS OR IMPLIED, IS MADE TO THE ACCURACY OR COMPLETENESS OF THE INFORMATION CONTAINED HEREIN, AND SAME IS SUBMITTED SUBJECT TO ERRORS, OMISSIONS, CHANGE OF PRICE, RENTAL OR OTHER CONDITIONS, WITHDRAWAL WITHOUT NOTICE, AND TO ANY SPECIAL LISTING CONDITIONS IMPOSED BY THE PROPERTY OWNER(S). AS APPLICABLE, WE MAKE NO REPRESENTATION AS TO THE CONDITION OF THE PROPERTY (OR PROPERTIES) IN QUESTION.

